



C. Earl Hunter, Commissioner

Promoting and protecting the health of the public and the environment.

PUBLIC NOTICE AMENDMENT REQUEST

The permittee for P/N# OCRM-06-565, R. C. Blevins, has requested an after-the-fact amendment to that issued permit. Specifically, the applicant seeks approval for the construction of a 60' vinyl bulkhead located 18" channelward of the existing bulkhead and the addition of a 13' x 13' boatlift placed on the ebbside of the existing fixed pierhead. The applicant also seeks approval for the construction of a 25' x 10' floating dock, by removing a 6' x 25' portion of what was built, which was increased in size from the originally permitted 12' x 16' floating dock. This proposed request is for after-the-fact modifications to a private recreational dock, on and adjacent to Main Creek at Lot 2 of Creekside Dr, Garden City, Horry County, South Carolina.

CMS
Written comments will be received on this amendment request until July 13, 2008 at the address listed below. For further information please contact the project manager, Christopher Stout, 843-238-4528.

July 3, 2008

SOUTH CAROLINA DEPARTMENT OF HEALTH AND ENVIRONMENTAL CONTROL


Occan and Coastal Resource Management

Myrtle Beach Office • 927 Shine Avenue • Myrtle Beach, SC 29588

Phone: 843-238-4528 • Fax: 843-238-4526 • www.scdhec.gov



CREEKSIDE DRIVE
(40' R/W)

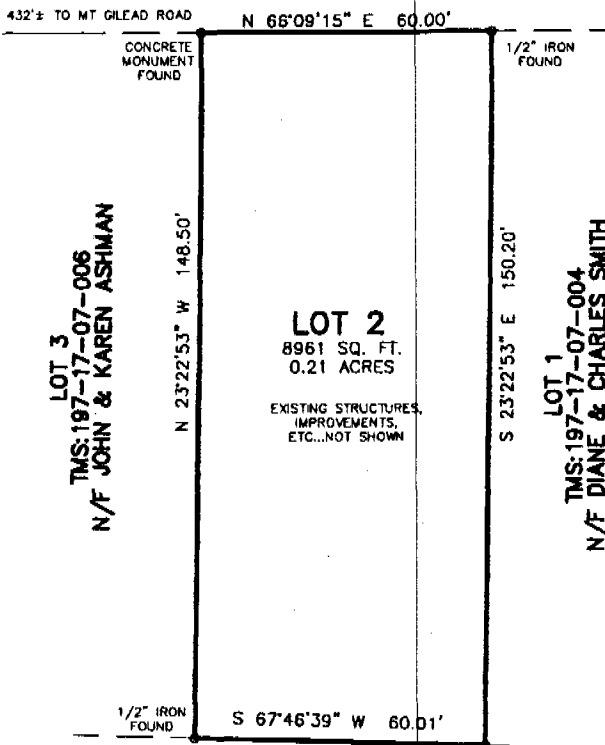


LOT 3
TMS:197-17-07-008
N/F JOHN & KAREN ASHMAN

LOT 1
TMS:197-17-07-004
N/F DIANE & CHARLES SMITH

RECEIVED



APR 16 2008

DHEC-OCRM
MURTLF BEACH OFFICE

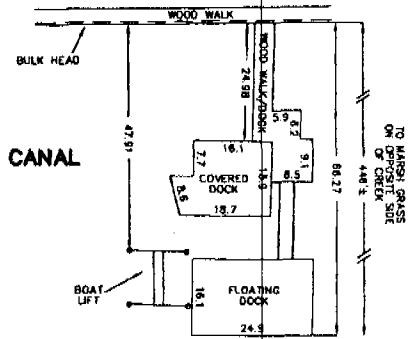

THIS PROPERTY IS LOCATED IN FLOOD ZONE AE-13, ACCORDING TO F.I.R.M. No. 45051C0734 H, DATED AUGUST 23, 1998.

FLOOD ZONE LOCATIONS ARE SCALED FROM CURRENT FEMA RATE MAPS. SCALES VARY FROM 1"=100' TO 1"=2000' AND ARE NOTED AS BEING APPROXIMATE ON SAID MAPS. CULLER LAND SURVEYING CO., INC. DOES NOT CERTIFY TO OR ASSUME RESPONSIBILITY FOR THE ACCURACY OF THE FLOOD ZONE LINES.

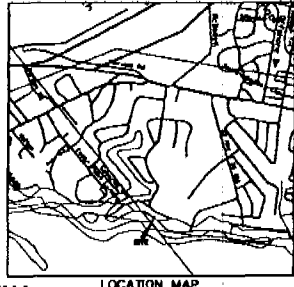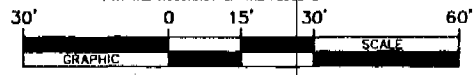

PLAT PREPARED FOR
R.C. BLEVINS Jr.

MURRELLS INLET-HORRY COUNTY-SOUTH CAROLINA

THE SAME BEING ALSO SHOWN AS LOT 2 ON A PLAT OF LOTS 1-14 FOR MT. GILEAD
BY JOHNSON & ROBERTS DATED JUNE 1961
AND RECORDED IN THE OFFICE OF THE CLERK OF COURT FOR HORRY COUNTY
IN PLAT BOOK 35 AT PAGE 38.

REVISED APRIL 3, 2008


"I HEREBY STATE THAT TO THE BEST OF MY KNOWLEDGE, INFORMATION, AND BELIEF, THE RESURVEY SHOWN HEREIN WAS MADE IN ACCORDANCE WITH THE REQUIREMENTS OF THE MINIMUM STANDARDS MANUAL FOR THE PRACTICE OF LAND SURVEYING IN SOUTH CAROLINA, AND MEET OR EXCEEDS THE REQUIREMENTS FOR A CLASS SURVEY AS SPECIFIED THEREIN; ALSO THERE ARE NO VISIBLE ENCROACHMENTS OR PROJECTIONS OTHER THAN SHOWN." THIS LOT IS SUBJECT TO ANY EASEMENTS OR RESTRICTIONS OF RECORD. THIS PLAT IS THE PROPERTY OF CULLER LAND SURVEYING CO., INC., IS CERTIFIED ONLY TO THE PERSONS OR ENTITY NAMED HEREIN, AND MUST HAVE THE ORIGINAL SIGNATURE AND RAISED SEAL TO BE VALID.

Michael S. Culler, Jr.
MICHAEL S. CULLER, JR.
S.C. REGISTERED LAND SURVEYOR No. 5210


DATE: FEB. 1, 2007	SCALE: 1" = 30'
CULLER LAND SURVEYING CO., INC.	
(843) 238-2333	
P.O. BOX 14327	
LS-12188	
SURFSIDE BEACH S.C. 29587	

Not
to
Scale

OCRM-06-565

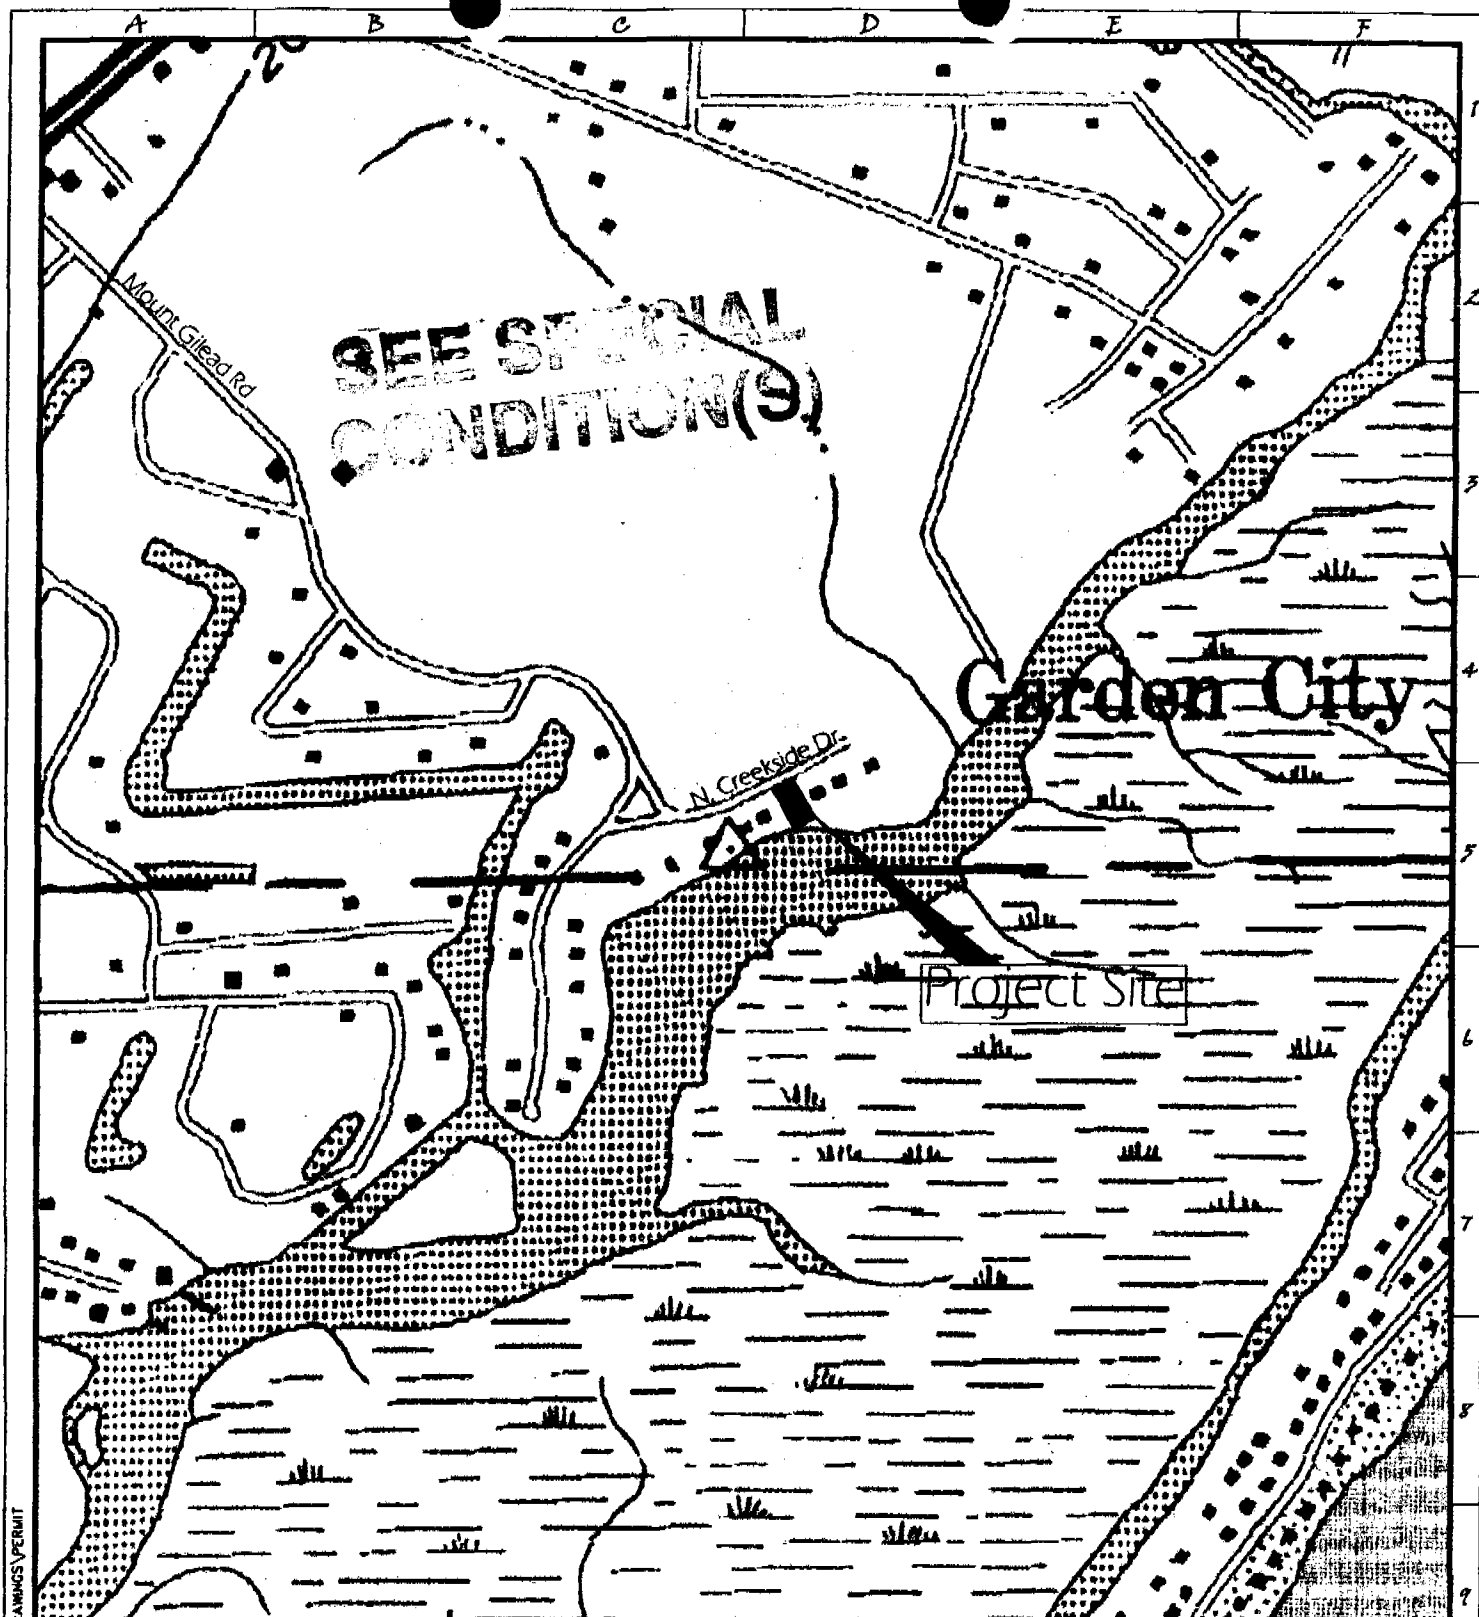

M:\JOBS\2002\00787-0218\DRAWINGS\PERMIT

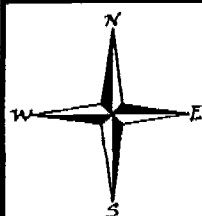

LOCATION MAP
BLEVINS DOCK REHABILITATION
HORRY COUNTY, SOUTH CAROLINA
DOCK PERMIT APPLICATION

DATE: 11/13/06

PAGE 2/3

APPLICATION NO. **OCRN-06-565**

ADJACENT PROPERTY OWNERS

1. John & Karen Ashman
2. Diane & Charles Smith

OWNER/APPLICANT

R.C. Blevins
 117 Ashley River Rd
 Myrtle Beach, SC 29576

Note: This drawing is for permitting purposes only and is not to be used for construction.

AGENT: THE BRIGMAN COMPANY, INC., P.O. BOX 1532, CONWAY SC 29526 (843) 248-9388 FAX: (843) 248-9596

n. 5 of 7